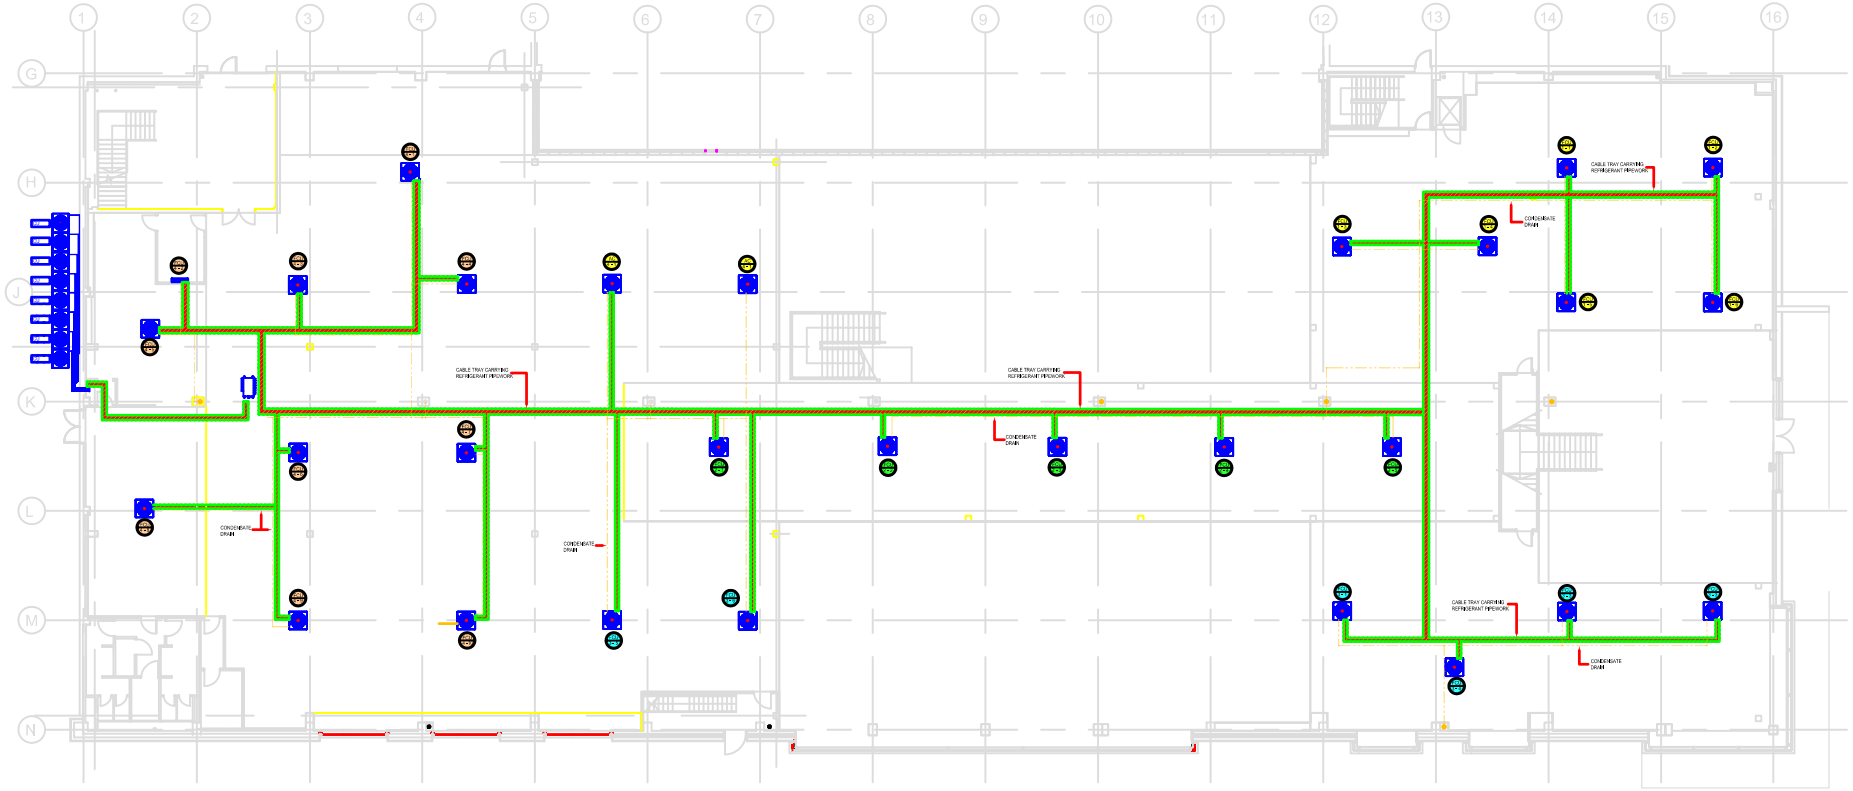

GROUND FLOOR

NOTES

COPYRIGHT
THIS DRAWING SHALL NOT BE REPRODUCED IN FULL OR PART OR HOLD WITHOUT WRITTEN APPROVAL

REV	ITEM	DATE

DRAWING REVISION

AS INSTALLED

kelvinair
air conditioning • cooling

kelvinair ltd
Sovereign Business Park • Butterley Street
Hunslet • Leeds • LS10 1AW
Telephone • 0113 243 5199 • Facsimile • 0113 243 5822
E-mail • info@kelvinair.co.uk
Web Site • www.kelvinair.co.uk

PROJECT TITLE

STOKERS - CHESTER

DRAWING TITLE

GROUND FLOOR
COMFORT COOLING

PROJECT No	DRAWN BY	DESIGNER
HA2464	SB/RW	RA
SCALE	SIZE	DATE
1:100 @ A0	A0	05:08:07
DRAWING NUMBER		REVISION NUMBER
M001		