NOTES
COPYRIGHT
THIS DRAWING SHALL NOT BE REPRODUCED IN FULL OR PART OR USED WITHOUT WRITTEN APPROVAL

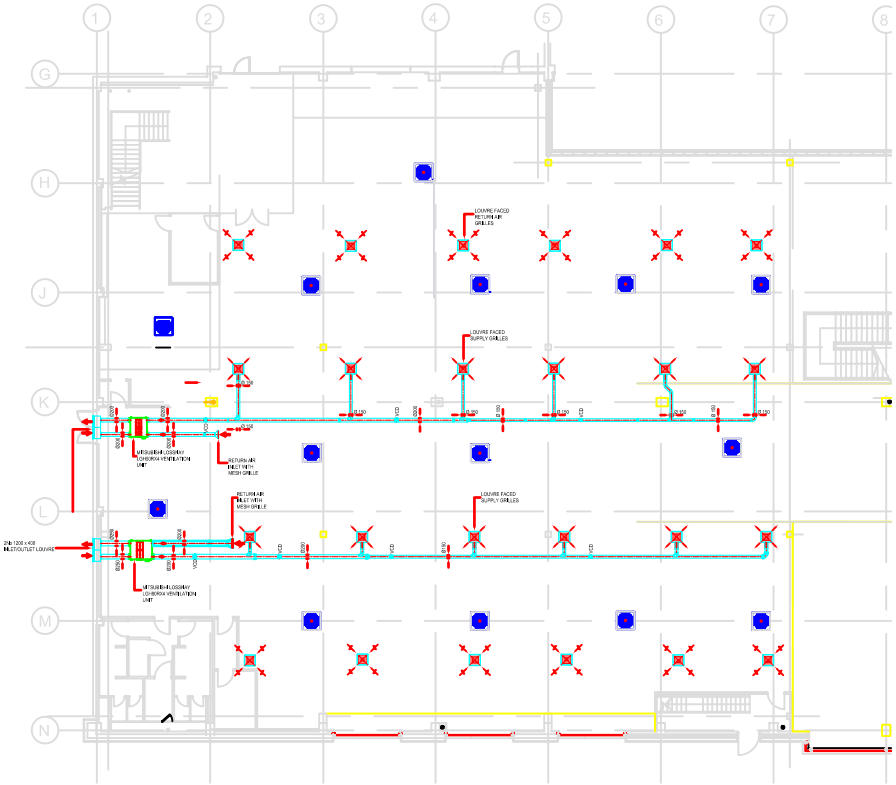

Ground Floor

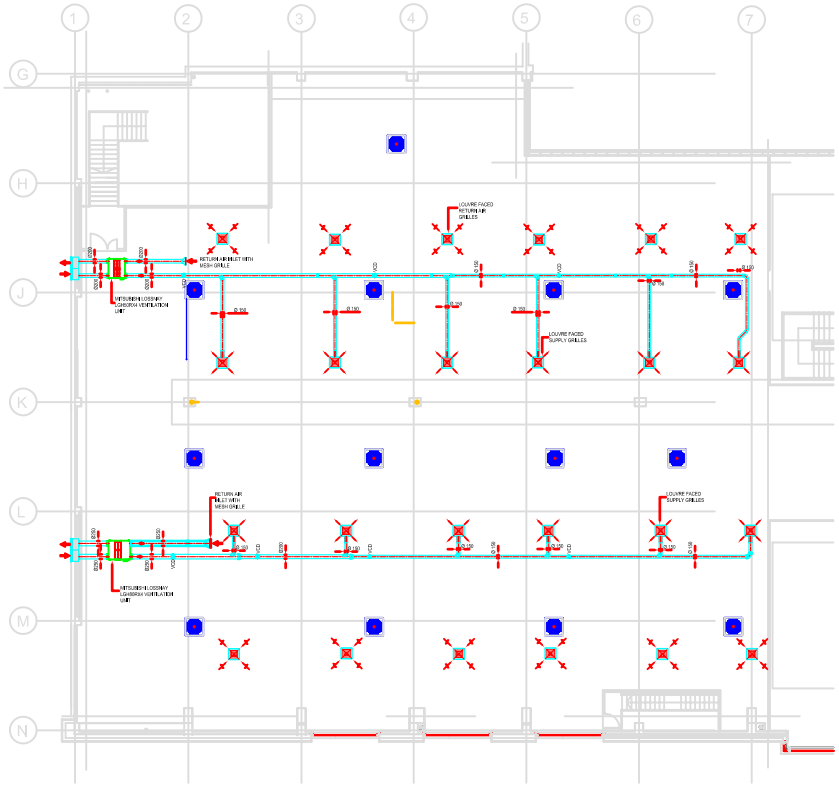

First Floor

REV	ITEM	DATE

DRAWING REVIEW

AS INSTALLED

kelvinair
air conditioning • cooling

kelvinair ltd
Sovereign Business Park • Butterley Street
Hunslet • Leeds • LS10 1AW
Telephone • 0113 243 5199 • Facsimile • 0113 243 5822
E-mail • info@kelvinair.co.uk
Web Site • www.kelvinair.co.uk

PROJECT TITLE

STOKERS - CHESTER

DRAWING TITLE

LAYOUT OF GROUND AND FIRST FLOOR VENTILATION SYSTEM

PROJECT No	DRAWN BY	ENGINEER
RA2624	SB/RW	RA
SCALE	SIZE	DATE
1:100 @ A0	A0	05-08-07
DRAWING NUMBER		REVISION NUMBER
M003		